


REV.	ZONE	CHK. #	DESCRIPTION	CC APPD.	ENG APPD.
A	V999		PRODUCTION RELEASE		
B	V1085		REVIEW RELEASE		

- NOTE: IMISC IN:WD COME SMCARD
- ALL RESISTANCE VALUES ARE IN OHMS, 1/4W, 57V
 - ALL CAPACITANCE VALUES ARE IN MICROFARADS
 - COMPONENT CRT NOT INSERTED
 - J16:PN515-0050 (2 POSITION, 2 PIN HEADER JUMPER)
 - WHEN USING THE D-P SAMI OPTION: DO NOT ASSEMBLE R32, R33, R39, OR R40. ASSEMBLE R32A, R33A, R39A, R40A, AND R42.
 - L4 FERRITE BEAD
 - REDRAW AMBIGUITIES/ERRORS MARKED IN RED, CORRECTIONS/ANNOTATIONS MARKED IN BLUE

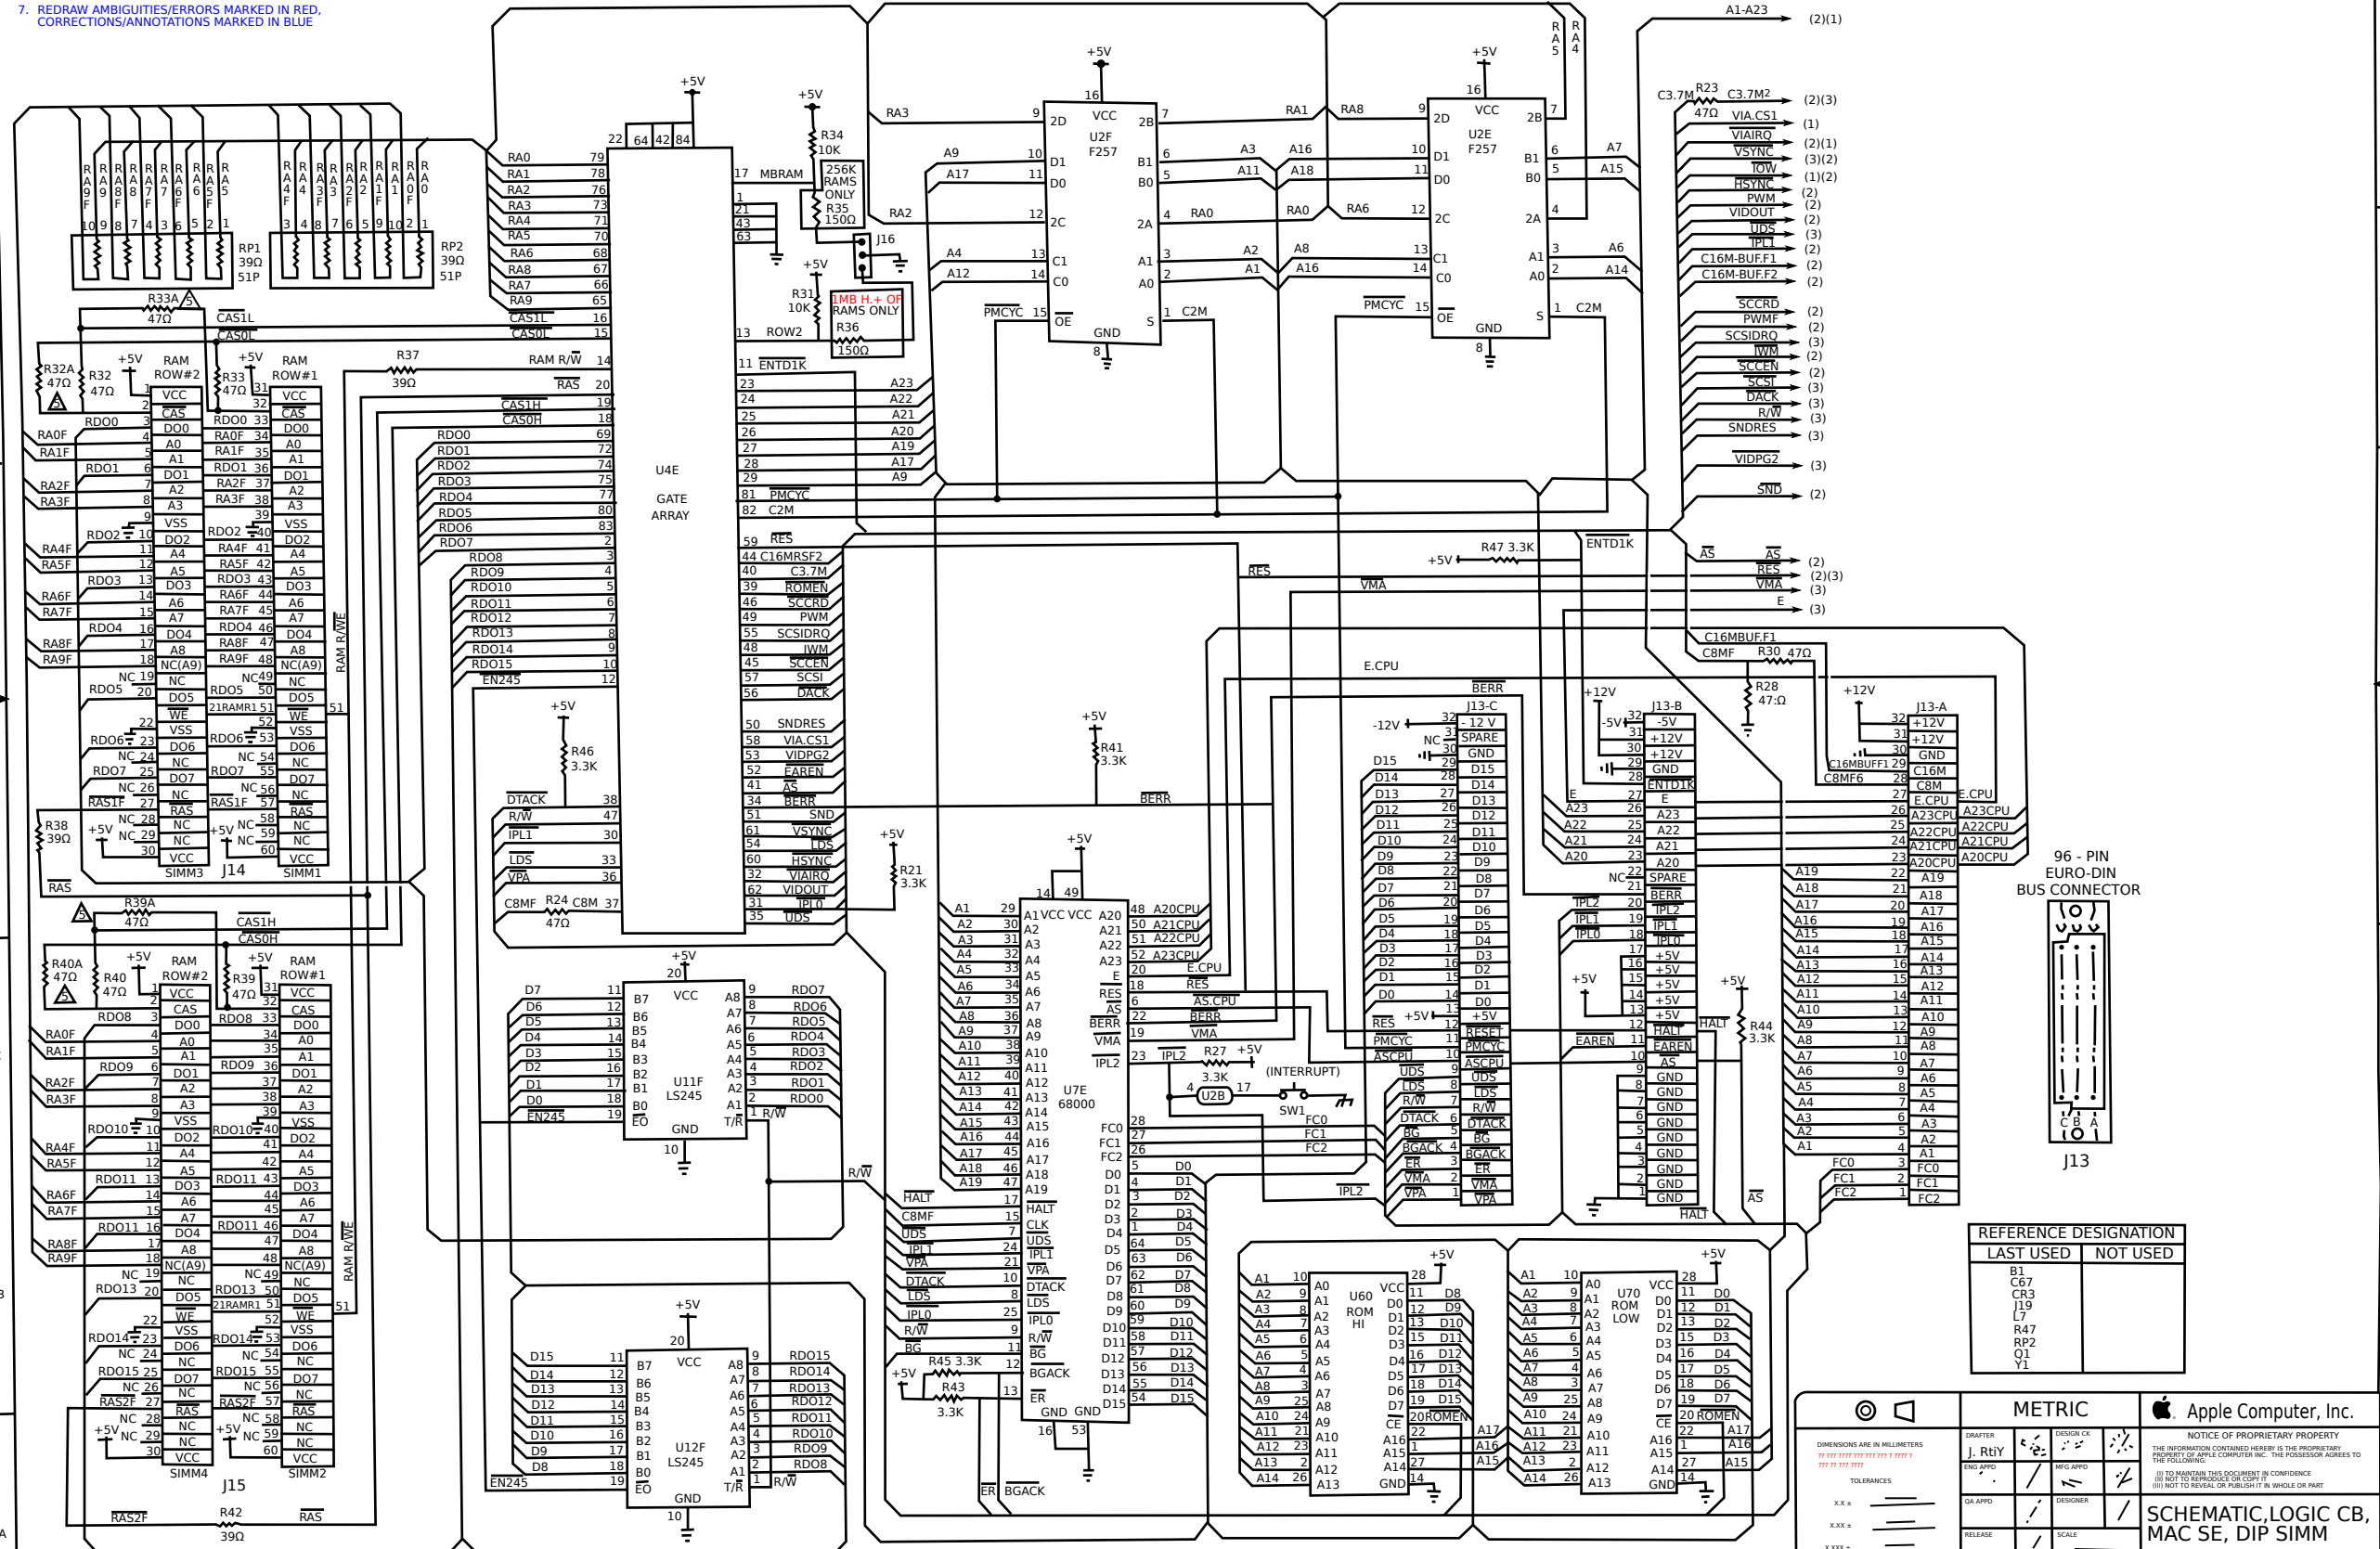

REFERENCE DESIGNATION	
LAST USED	NOT USED
B1	
C67	
CR3	
L19	
L7	
R47	
RP2	
Q1	
Y1	

		METRIC			
<small>DIMENSIONS ARE IN MILLIMETERS 10 100 1000 100 1000 1000 1000</small>		<small>NOTICE OF PROPRIETARY PROPERTY THE INFORMATION CONTAINED HEREIN IS THE PROPRIETARY PROPERTY OF APPLE COMPUTER, INC. THE POSSESSOR AGREES TO (1) TO MAINTAIN THIS DOCUMENT IN CONFIDENCE (2) NOT TO REPRODUCE OR COPY IT (3) NOT TO REVEAL OR PUBLISH IT IN WHOLE OR PART</small>		<small>NOTICE OF PROPRIETARY PROPERTY THE INFORMATION CONTAINED HEREIN IS THE PROPRIETARY PROPERTY OF APPLE COMPUTER, INC. THE POSSESSOR AGREES TO (1) TO MAINTAIN THIS DOCUMENT IN CONFIDENCE (2) NOT TO REPRODUCE OR COPY IT (3) NOT TO REVEAL OR PUBLISH IT IN WHOLE OR PART</small>	
<small>TOLERANCES</small> X.X = — X.XX = — X.XXX = — <small>ANGLES = —</small> <small>DO NOT SCALE DRAWINGS</small>	<small>DRAWER</small> J. RtiY <small>ENG APPD.</small> <small>QA APPD.</small> <small>RELEASE</small>	<small>DESIGN CK.</small> <small>WFG APPD.</small> <small>DESIGNER</small> <small>SCALE</small>	<small>DATE</small> <small>SIZE</small> E	<small>DRAWING NUMBER</small> 050-0432-6	<small>SHEET</small> 1/3
SCHMATIC, LOGIC CB, MAC SE, DIP SIMM				<small>DRAWING NUMBER</small> 050-0432-6	

050-0432-6-1/3